

# MARION COUNTY SURVEYOR'S OFFICE



## SECTION CORNER RECORD

DEBRA S. JENKINS  
MARION COUNTY SURVEYOR

SEC. 33 TWN. 16<sub>N</sub> RNG. 4<sub>E</sub>

BRYAN F. CATLIN, PLS  
TECHNICAL SUPERVISOR

Date: 5-1-09  
Party Chief: Wilcoxon  
Crew: Finney  
Type of Marker: Harrison  
Method of Establishment: County: 7-14-01  
IN S.P.C. E Zone, NAD 83  
Name: 16043305  
N: 504 158.368 2 (m)  
E: 63 500.391 9(m)

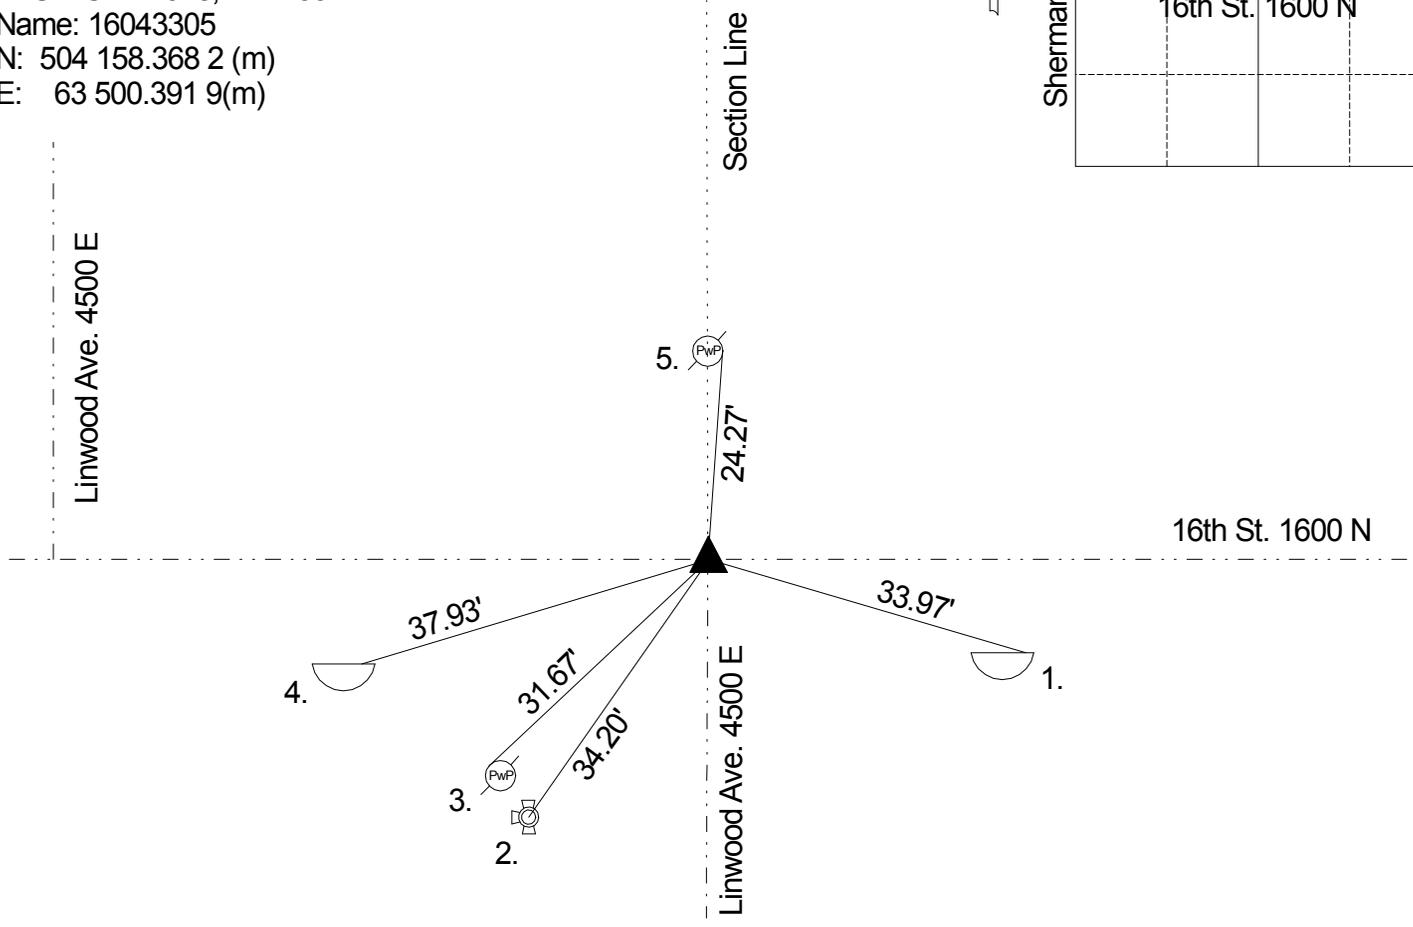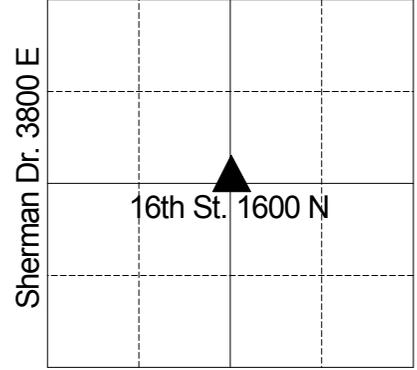

A survey by John Coyner on May 18, 1900 indicates no stone or witnesses. ( Center Legal Book p. 15 ) An old tie card with no date called for an iron bolt. Corner referenced by McLand on 7/11/74 and called a cut x in concrete pavement. Corner referenced by Wilcoxon on 2/3/76 and called a cut x in concrete pavement. Corner referenced by Gries on 11/30/87 and called a cut x in concrete pavement. Corner referenced by Kiste on 8/14/96 and called a r. r. spike. Corner referenced by Wilcoxon on 7/14/01 and called a r. r. spike. Corner referenced by Wilcoxon on 10/14/06 and called a r. r. spike. Corner excavated by Wilcoxon on 4/29/09 and a hole where the r. r. spike was per ties was found. No other points were found. A # 205 cast iron Harrison Monument was set in position as the monument . Ties were updated by Wilcoxon on 5/1/09.

REF.	DISTANCE	DESCRIPTION
1.	33.97'	Cut 'x' NE corner of inlet
2.	34.20'	Top nut of fire hydrant
3.	31.67'	Mag nail w/ bw NW PwP #634-512 A 2" up
4.	37.93'	NE corner of inlet
5.	24.27'	Mag nail w/ bw E PwP no# 4" up

THIS CORNER POSITION REPRESENTS A "TITLE" CORNER AND MAY NOT NECESSARILY REPRESENT THE POSITION BASED ON RECORD CORNERS.